

PERMIT FOR CONSTRUCTION OF SUBSURFACE SEWAGE DISPOSAL SYSTEM

45⁰⁰ Rec. 15014

149021


Issued to: <u>Ever Dick</u> Owner, Developer, Contractor, Installer, Etc.	REGION <u>2</u>	COUNTY <u>05</u>	ID-NUMBER	DATE <u>09-12-86</u>
	STAFF <u>008</u>	INSTALLATION: <input checked="" type="checkbox"/> 1. New Installation <input type="checkbox"/> 2. Repair to Existing System		
To be constructed by <u>Edward Proffitt</u> (Installer)	Type of System: <input checked="" type="checkbox"/> 1. Standard <input checked="" type="checkbox"/> 2. Alternating		<input type="checkbox"/> 3. Chapter 301	<input type="checkbox"/> 5. Other <input type="checkbox"/> 4. Chapter 212
Construction of a subsurface sewage disposal system is hereby authorized at: <u>at Perry's mill, off Walland Pike</u> (No. and street; Subdivision name and lot no.)	For: <input type="checkbox"/> 1. Residential: No. B/R _____ <input checked="" type="checkbox"/> 2. Commercial/Industrial; Gal/Day <u>1130</u> $\frac{1}{2} \times 35 = 32 \text{ seats}$			
Such a system shall consist of a septic tank of <u>1000</u> gals, with <u>1000</u> linear feet in <u>11</u> trenches, <u>36</u> inches wide, and <u>3'</u> deep	Evaluation based Upon: <input checked="" type="checkbox"/> 1. Soil Typing by Soil Scientist <input type="checkbox"/> 2. Soil Percolation Tests <input type="checkbox"/> 3. Other _____		Permeability Rate <u>30 min/inch</u>	

The recipient of this permit agrees to construct or have constructed the system in accordance with the rules and regulations under the authority of TCA 53-2054. The recipient must notify the local health authority when the system is ready for inspection. If any part of system is covered before being inspected and approved, it shall be uncovered by the recipient of the permit at the direction of the local health authority.

Edward Proffitt (Signature) Recipient-Owner, Developer, Contractor, Etc.) Date 05-26-86

Issued at Maryville Tennessee in the County of Blount

By B.C.H.D. Howard Crabtree (Local Health Authority) Date 05-26-86

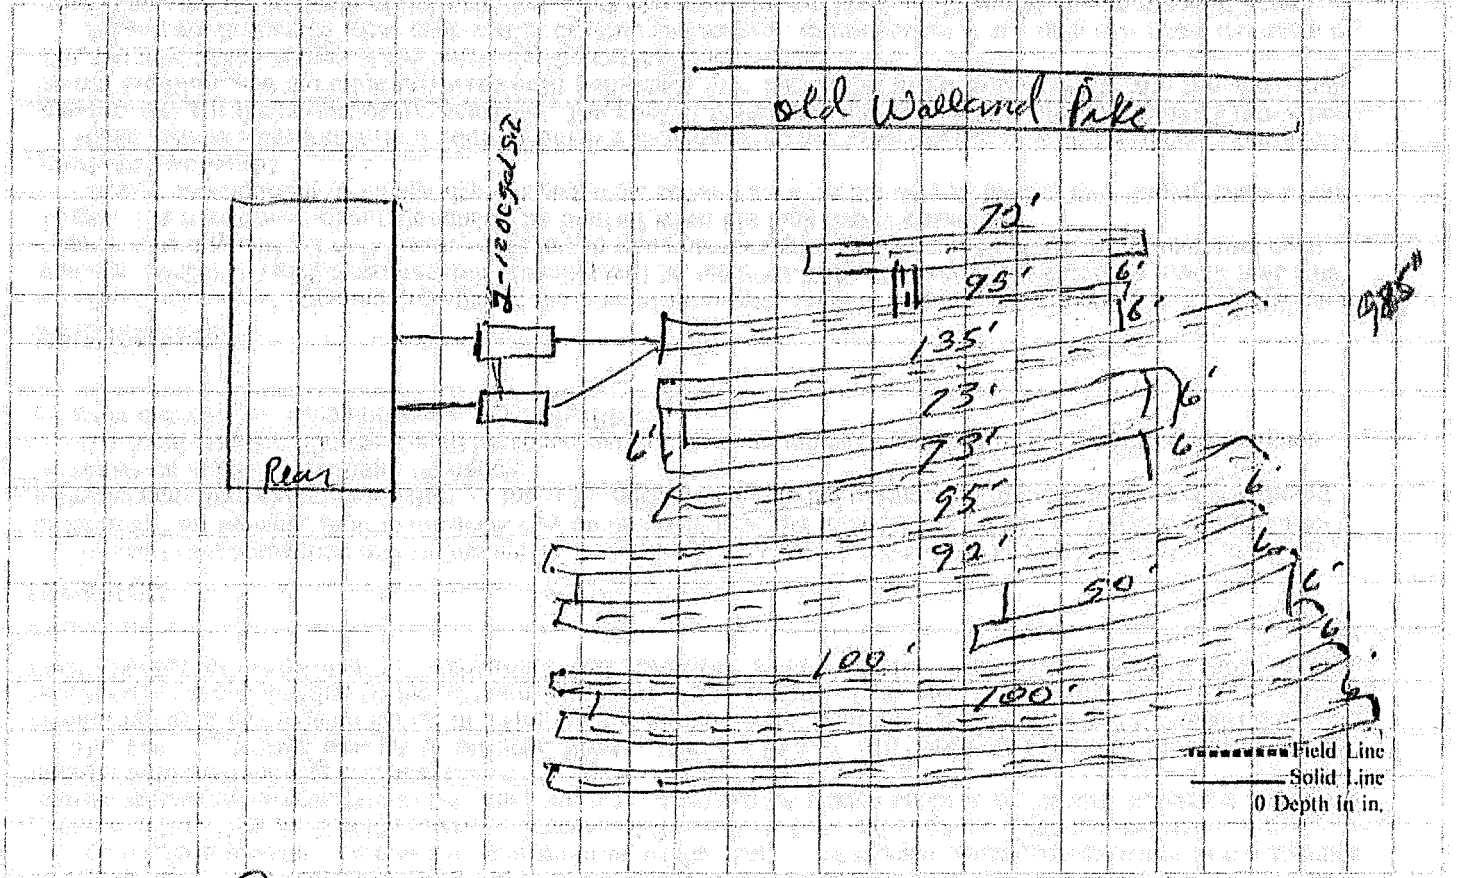

Inspected By Shel Daniels Local Health Authority Construction Approval: 1. Yes 2. No

Date 09-12-1986 No. of Visits: 6 Time 090